


COMPRESSED AIR SYSTEM

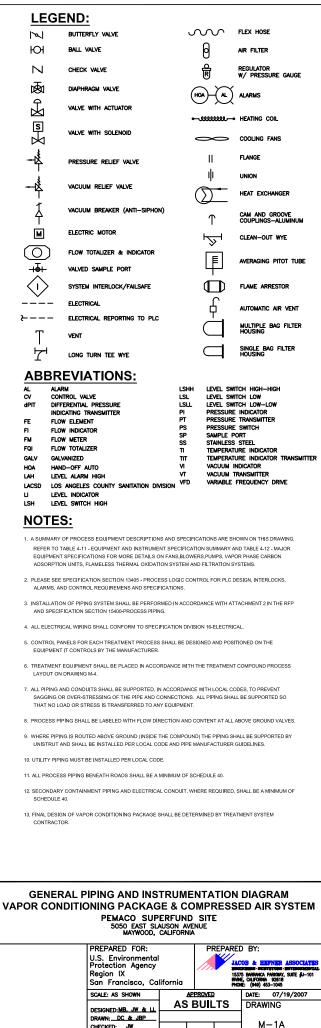

AS-BUILT

SILENCER